

DART SERVICE BULLETIN SB11-1

AFFECTING:
D412-791-047 PITOT HEAT MONITORING KIT
REF TCCA STC: SH09-37
REF FAA STC: SR02766NY
REF EASA STC: 10032253


PURPOSE:

WHEN D412-791-047 WAS INSTALLED ON **BELL 412 S/N 33101 - SUB**, THE PITOT HEAT MONITOR WOULD FAIL TO RECOGNIZE A POSSIBLE LOW CURRENT SITUATION. WHEN THE STATIC HEAT WAS CONNECTED TO THE CURRENT SENSING RELAY, THE LOW CURRENT OF THE PITOT HEAT WOULD NOT BE PROPERLY DETECTED.


INSTRUCTIONS:

REWIRE THE INSTALLATION IN ACCORDANCE WITH D412-791-907 REV. C.

IS:

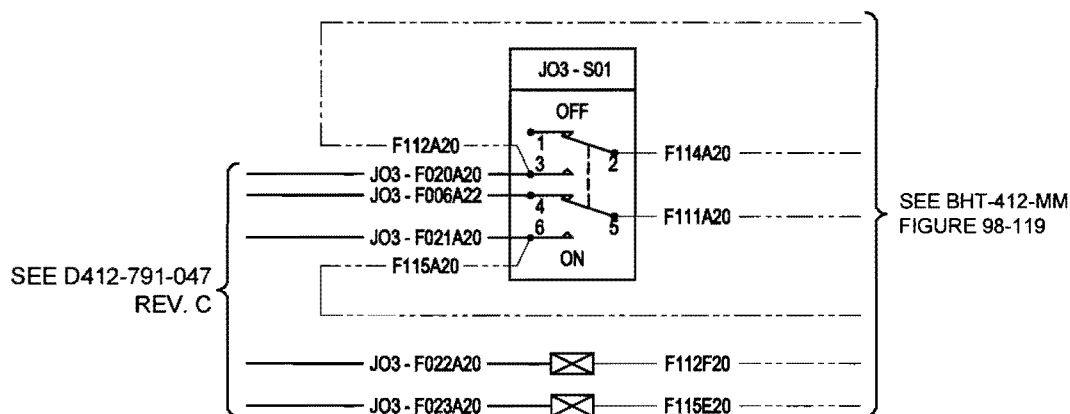

WAS:

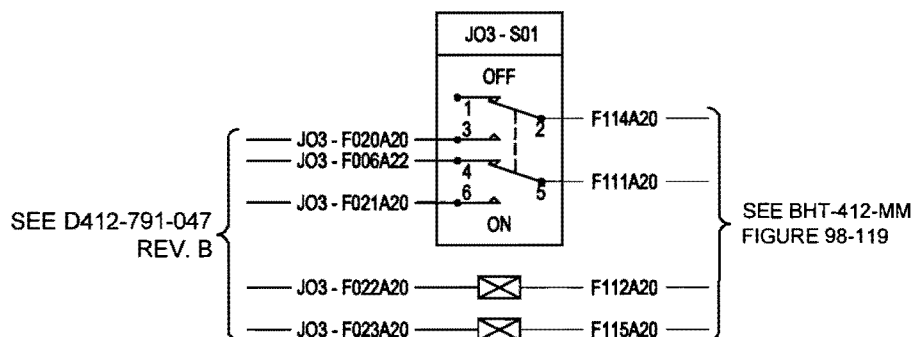

A	NEW ISSUE	KB	11.01.11
REV.	DESCRIPTION	BY	DATE
DESIGN	<i>KB</i>	DART AEROSPACE LTD HAWKESBURY, ONTARIO, CANADA	
DRAWN	<i>KB</i>		
CHECKED	<i>GL</i>	DRAWING NO.	REV. A
MFG. APPR.	<i>GL</i>	SB11-1	SHEET 1 OF 1
APPROVED	<i>TH</i>	TITLE	SCALE
DE APPR.	<i>TH</i>	SERVICE BULLETIN - PITOT HEAT	NTS
DATE	11.01.11	COPYRIGHT © 2011 BY DART AEROSPACE LTD THIS DOCUMENT IS PRIVATE AND CONFIDENTIAL AND IS SUPPLIED ON THE EXPRESS CONDITION THAT IT IS NOT TO BE USED FOR ANY PURPOSE OR COPIED OR COMMUNICATED TO ANY OTHER PERSON WITHOUT WRITTEN PERMISSION FROM DART AEROSPACE LTD.	